

FRANKLIN TOWNSHIP
FRANKLIN PARK SCHOOL


NOT TO SCALE

DATE: 03/06/2017

PROJECT NUMBER:

SCALE / REVISION:

DRAWN BY: CHECK BY:

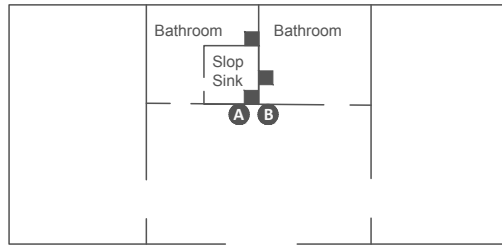


TRAILER



Franklin Park Annex

All Outlets Marked in RED have been found to have exceedances

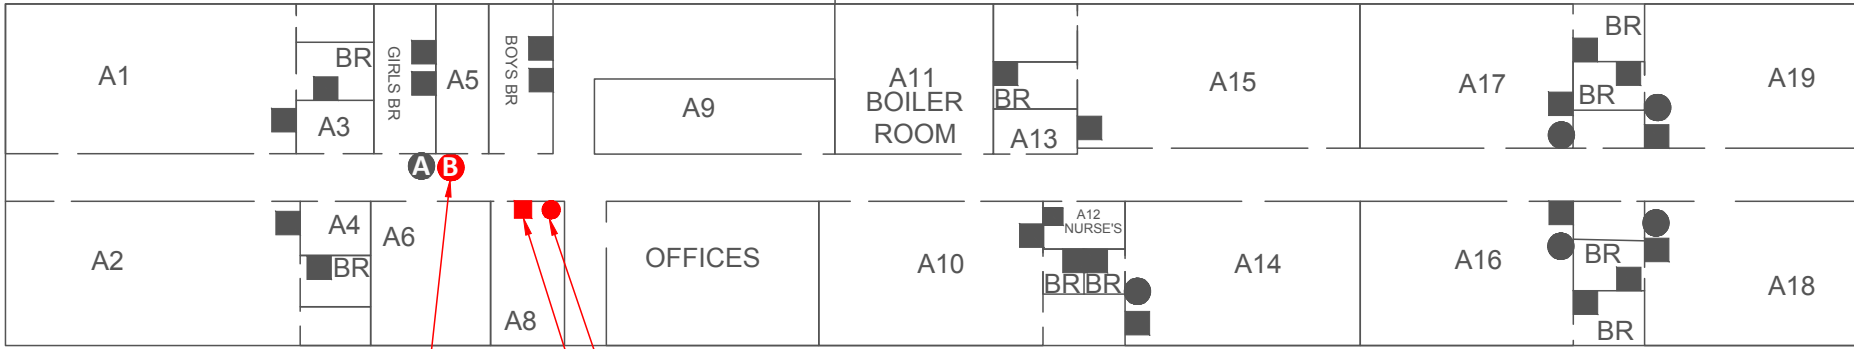

Drinking water fountain (B) in the 1st floor hallway by room A5 - 24.2 ppb

Drinking water fountain in 1st floor classroom A8 - 21.0 ppb

Faucet in 1st floor classroom A8 - 1260 ppb



FRANKLIN TOWNSHIP
FRANKLIN PARK SCHOOL (ANNEX)

NOT TO SCALE
03/06/17
PROJECT NUMBER:
DRAWING NUMBER: